

Chatham,
Mass.


Assessors' ID: 14H-51-B18A

OWNER OF RECORD:



18 Aire Lane LLC
Deed Book 29,168, Page 328
Plan Book 163, Page 145
Lot 18A

LOCATION TIES


	Elev	A	B
1	55.6	16	11
2	55.1	30	27
3	55.0	34	34
4	55.0	33	29

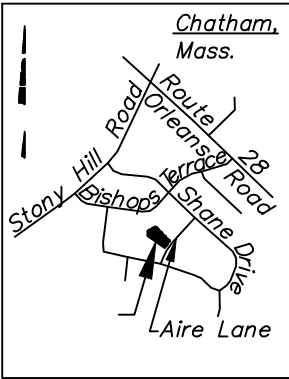


KEY MAP

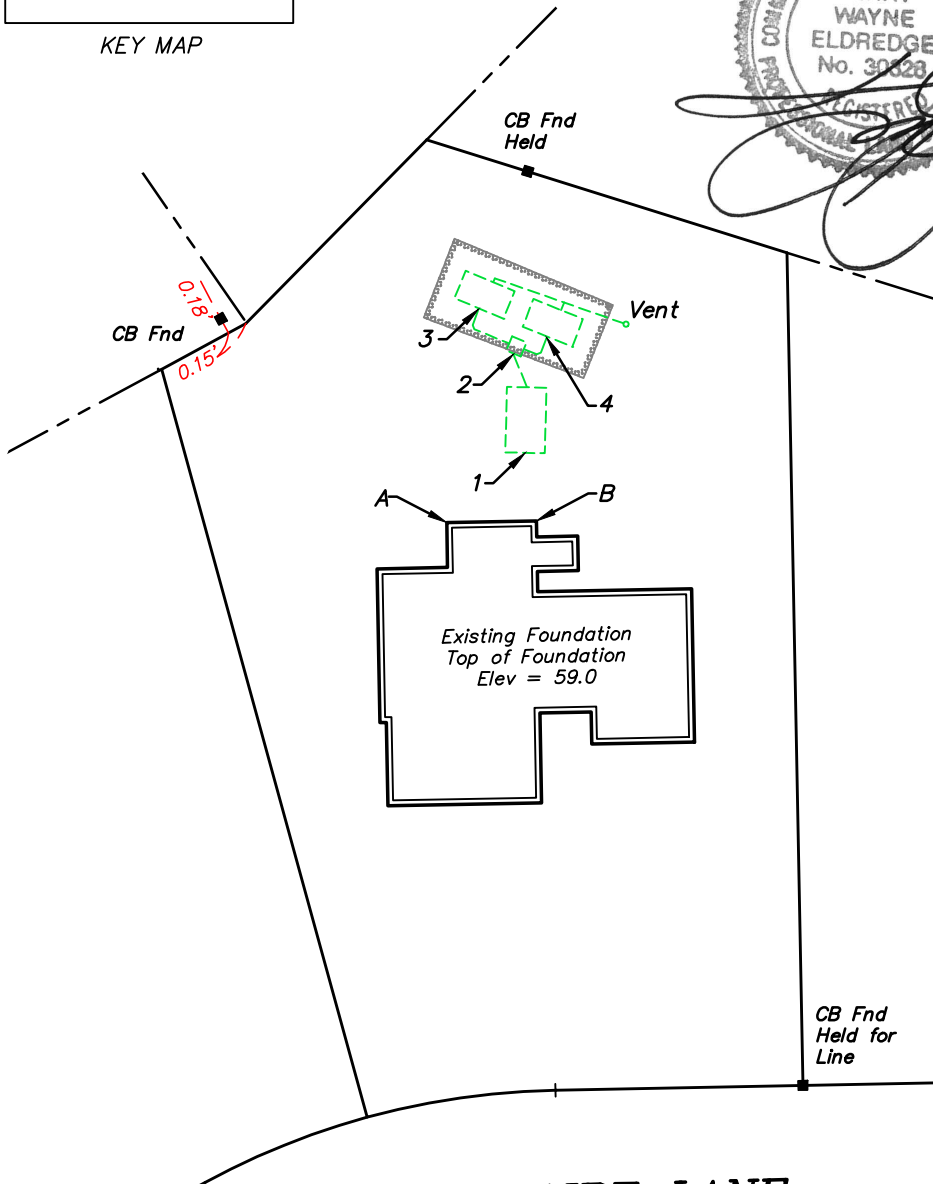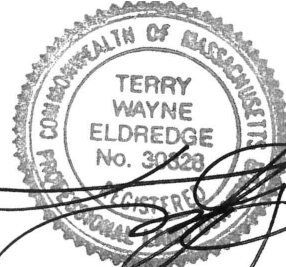

AIRE LANE
(40' Wide) (Town Road)

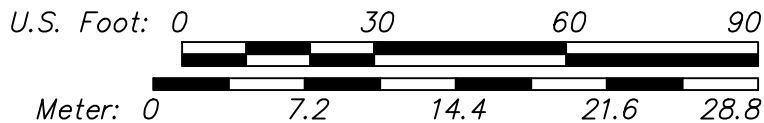

X: \ARCHIVED DRAWINGS\2313 040 - Summers, Sean - Aire Lane\Septic As-built\Septic As-built 2016-0504.dwg

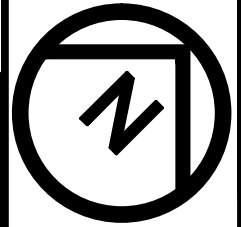

SEPTIC AS-BUILT PLAN
Lot 18A Aire Lane, Chatham, Massachusetts

#	Description of Revision	Date

AIRE LANE LLC

**ELDRIDGE SURVEYING
& ENGINEERING, LLC**
1038 Main Street, Chatham, MA 02633
(508) 945-3965; Fax: (508) 945-5885

Date: 05-09-2016
Scale: 1" = 30'
Project No.: C-2313-04.0

Sheet No.: 1 of 1