


CHECKLIST FOR SEWER SERVICE LATERAL INSTALLATION

Property Address: <u>16+ 18 Village Landing</u>	Street Served From: <u>Village Landing</u>
Date Work Completed: <u>3-7-18</u>	Contractor: <u>Robert Bow Co Inc</u>
Town: <u>CHATHAM</u>	Contract No. <u>2017-CWMP-1</u>
Sewer main diameter (nominal - inches): (circle one) <u>(8)</u> [10] [12] [Other] <u>Insulated DI</u>	Sewer lateral dia. (nominal - inches): (circle one) [4] <u>(6)</u> [8] [Other]
Connection to main sewer made with: (circle one) <u>(wye)</u> [tee] [saddle] <u>INS</u>	Lateral pipe material: (circle one) <u>INSULATED</u> <u>(DI)</u> [SDR 35] [SDR 26] []
Chimney installed? (circle one) [yes] <u>(no)</u>	Approx. depth below finished grade at service lateral end: (measured to top/crown of pipe) <u>3</u> feet
Approx. height of chimney: <u> </u> feet (measured from crown of pipe to top of chimney)	Date marking tape installed: <u>3-7-18</u> ; Approx. depth installed below grade <u>1</u> feet
Distance from nearest downstream manhole: <u>144</u> feet;	Stake installed marking end of lateral: (circle one) <u>(yes)</u> [no]; if no, reason: <u> </u>
Downstream manhole number: <u>425</u>	Date end cap installed: <u>3-7-18</u>

Location sketch

Show minimum of three referenced swing ties to permanent objects shown on Contract Drawings. Show house and street outlines. Show North arrow.

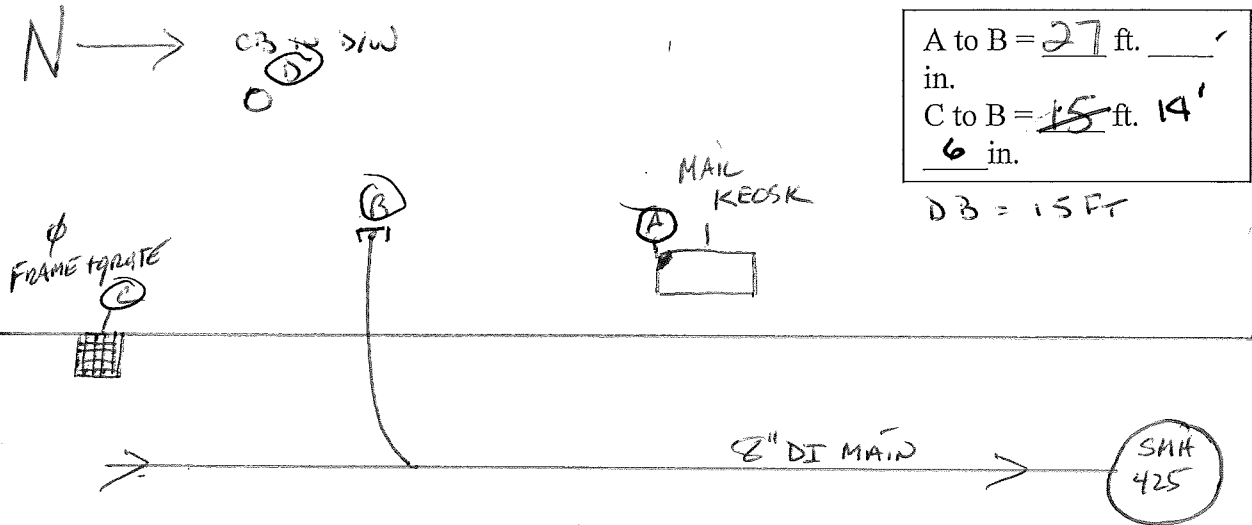

<u>Brian Montiero</u> 3-8-18 <small>(CONTRACTOR SIGNATURE AND DATE)</small>	<u>Robert Bersini</u> 3/19/18 <small>(RESIDENT PROJECT REPRESENTATIVE SIGNATURE AND DATE)</small>
<u>Brian Montiero</u> <small>[contractor name printed]</small>	<u>ROBERT BERSINI</u> <small>[resident project representative name printed]</small>
Contractor's Representative	Resident Project Representative

NOTE: The lateral locations are considered approximate and all horizontal and vertical dimensions shall be verified in the field prior to the commencement of any work related to the installation or connection of service laterals on private property.