


CHECKLIST FOR SEWER SERVICE LATERAL INSTALLATION

Property Address: <u>32 Village Landing</u>	Street Served From: <u>Village Landing</u>
Date Work Completed: <u>3-7-18</u>	Contractor: <u>ROBERT BOURCQ INC.</u>
Town: <u>CHAFFAM</u>	Contract No. <u>2017-CWMP-1</u>
Sewer main diameter (nominal - inches): (circle one) <input checked="" type="checkbox"/> 8 <input type="checkbox"/> 10 <input type="checkbox"/> 12 <input type="checkbox"/> Other <u>INS. DI</u>	Sewer lateral dia. (nominal - inches): (circle one) <input type="checkbox"/> 4 <input checked="" type="checkbox"/> 6 <input type="checkbox"/> 8 <input type="checkbox"/> Other <u> </u>
Connection to main sewer made with: (circle one) <input checked="" type="checkbox"/> wye <input type="checkbox"/> tee <input type="checkbox"/> saddle	Lateral pipe material: (circle one) <input checked="" type="checkbox"/> DI <input type="checkbox"/> SDR 35 <input type="checkbox"/> SDR 26 <input type="checkbox"/> <u> </u> INS. DI
Chimney installed? (circle one). <input type="checkbox"/> yes <input checked="" type="checkbox"/> no	Approx. depth below finished grade at service lateral end: (measured to top/crown of pipe) <u>4</u> feet
Approx. height of chimney: <u> </u> feet (measured from crown of pipe to top of chimney)	Date marking tape installed: <u>3-7-18</u> ; Approx. depth installed below grade <u>1</u> feet
Distance from nearest downstream manhole: <u>36</u> feet. ;	Stake installed marking end of lateral: (circle one) <input checked="" type="checkbox"/> yes <input type="checkbox"/> no ; if no, reason: <u> </u>
Downstream manhole number: <u>426</u>	Date end cap installed: <u>3-7-18</u>

Location sketch

Show minimum of three referenced swing ties to permanent objects shown on Contract Drawings.
Show house and street outlines. Show North arrow.

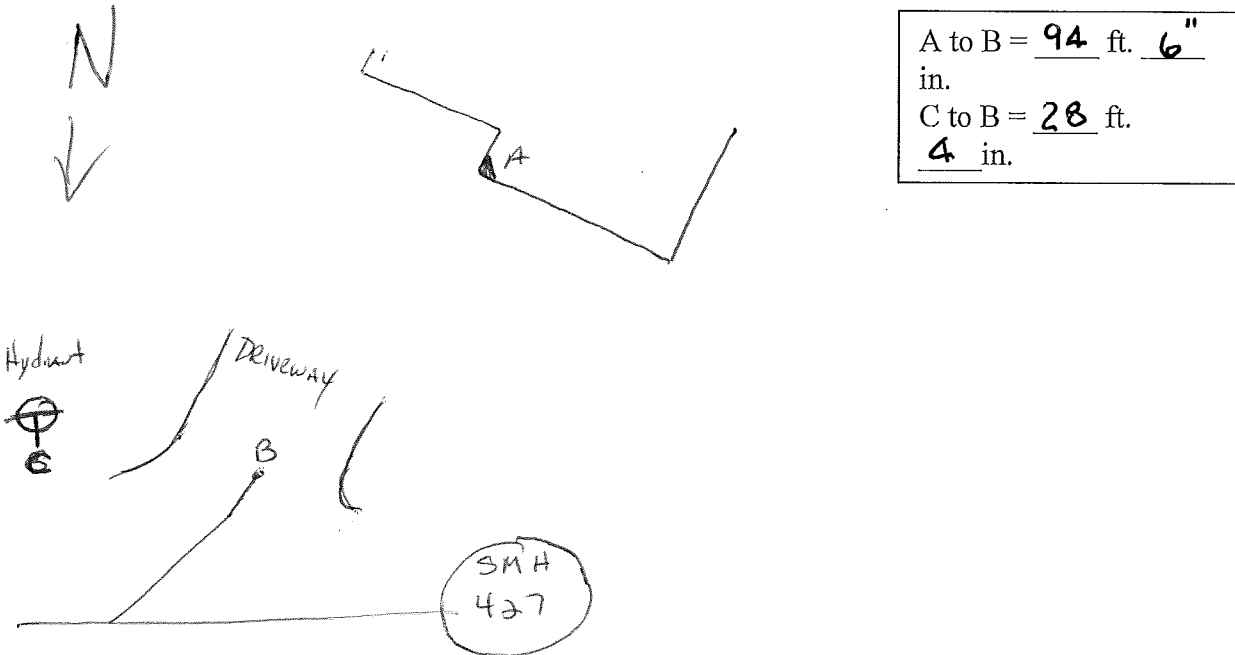

<u>B. Mat</u> <u>3-7-18</u> <small>[CONTRACTOR SIGNATURE AND DATE]</small>	<u>RLB</u> <u>3-18-2018</u> <small>[RESIDENT PROJECT REPRESENTATIVE SIGNATURE AND DATE]</small>
<u>Brian Martiero</u> <small>[contractor name printed]</small>	<u>ROBERT BERSIN</u> <small>[resident project representative name printed]</small>
Contractor's Representative	Resident Project Representative

NOTE: The lateral locations are considered approximate and all horizontal and vertical dimensions shall be verified in the field prior to the commencement of any work related to the installation or connection of service laterals on private property.